


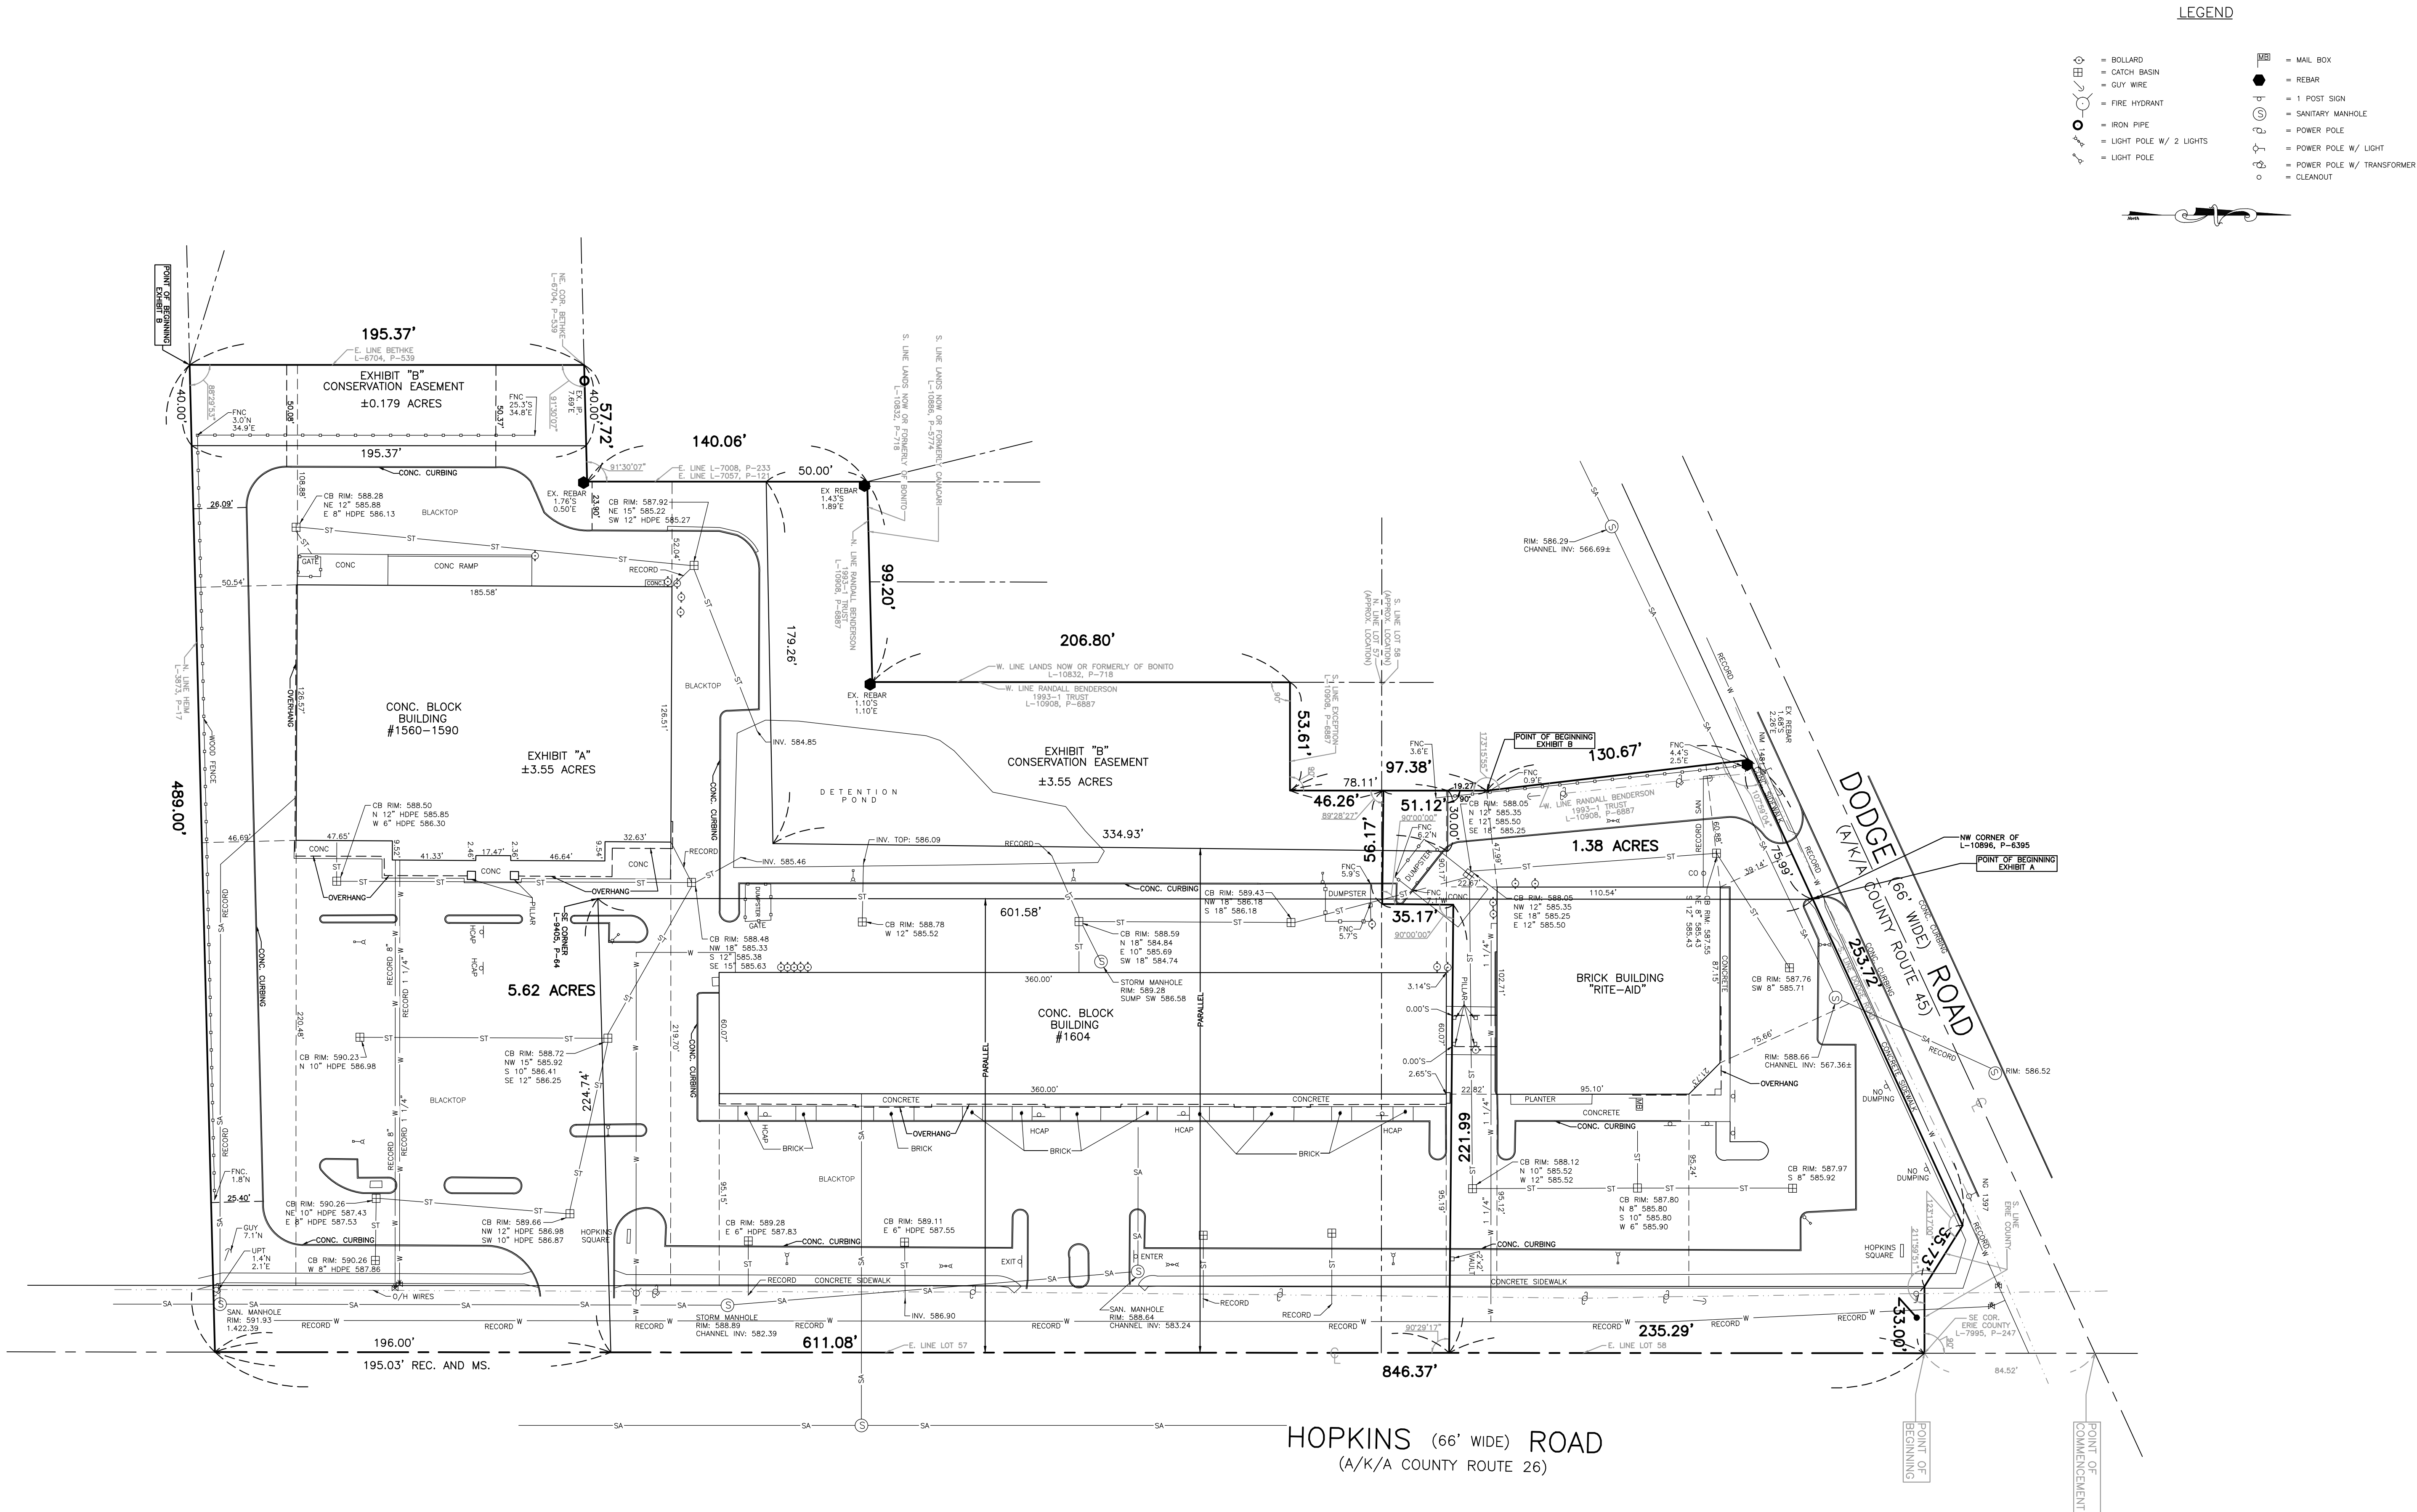

Designed by: MT
Office Date: 6/22/15
Job No. 15W100

Drawn by: AMP
Book: 412
Page: 9

Checked by: DRY
Map: 62759
File Name: Rite-Aid

Dwg Scale: Horiz: 1"=40'
Vert: N/A

KHEOPS
ARCHITECTURE, ENGINEERING
& SURVEY, DPC
300 Pearl Street, Suite 100
Buffalo, New York 14202
P: 716.856.0981
F: 716.856.0981
WWW.KHEOPSPC.COM

PARCEL DIVISION MAP
HOPKINS SQUARE PLAZA
HOPKINS ROAD, TOWN OF AMHERST
COUNTY OF ERIE, STATE OF NEW YORK

MAP
NUMBER:
62759

Sheet 1 of 1

NO.	DATE	REVISION	DESCRIPTION
1	6/22/15		ISSUED FOR PERMIT
2	7/10/2015		REVISIONS TO PERMIT
3	4/19/16		AS-BUILT